
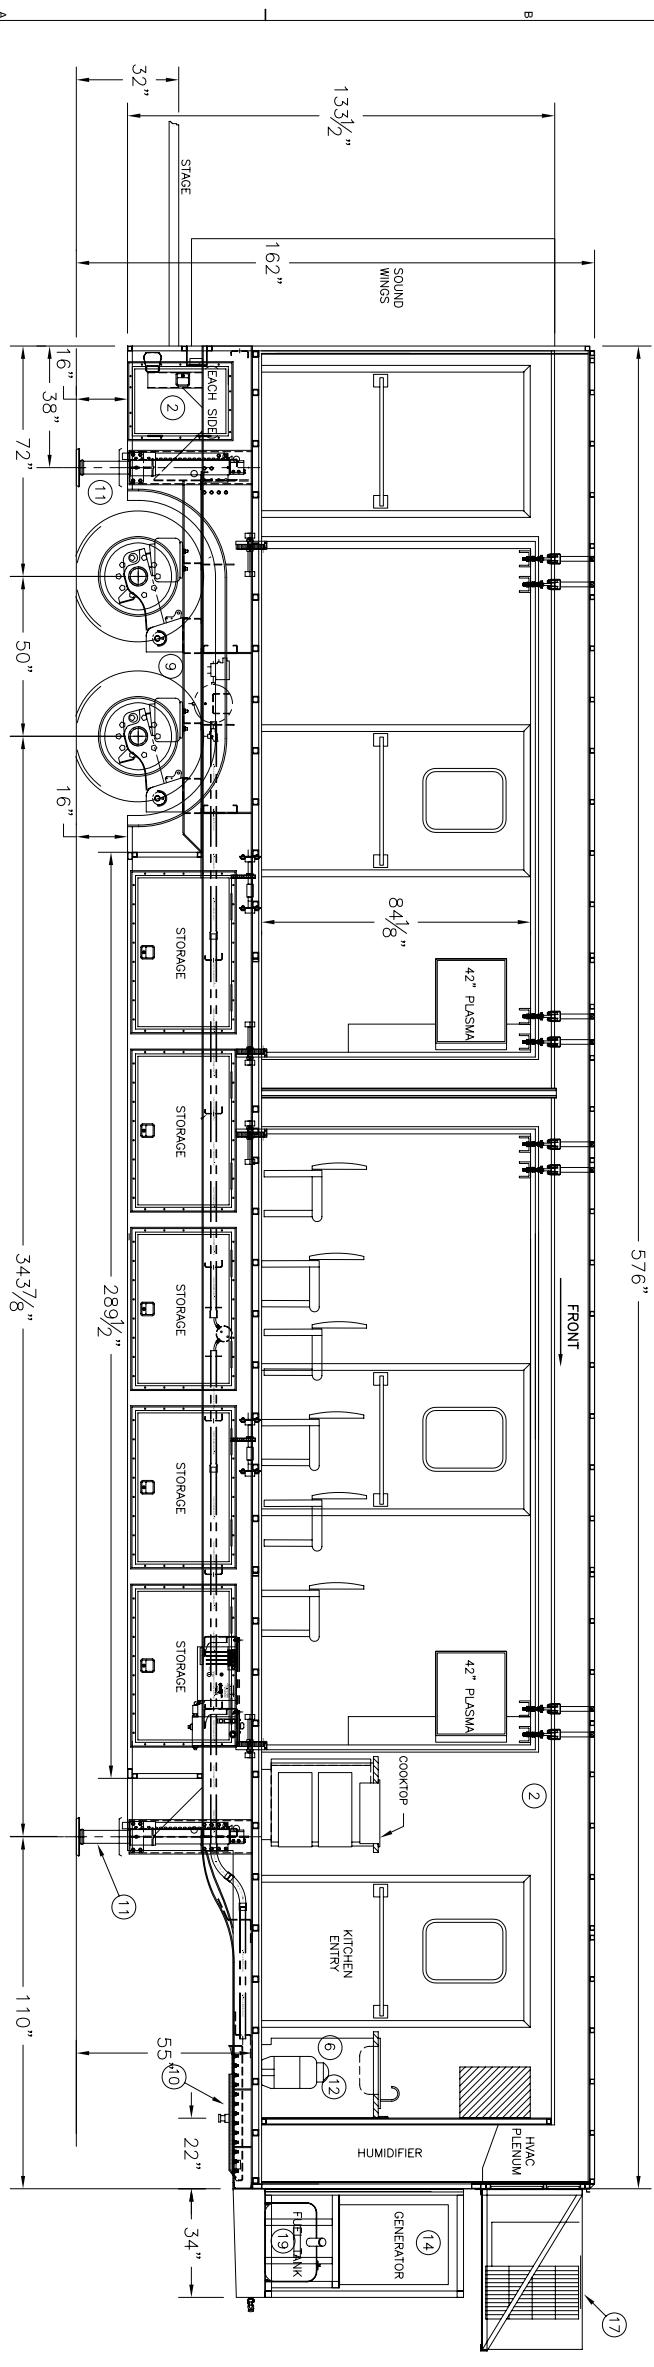


REV	REV. DATE	CHK. BY	CHK. DATE	ENG.	DESCRIPTION
04	16OCT03	PKK	16OCT03	GH	AS-BUILT

2 REVISIONS

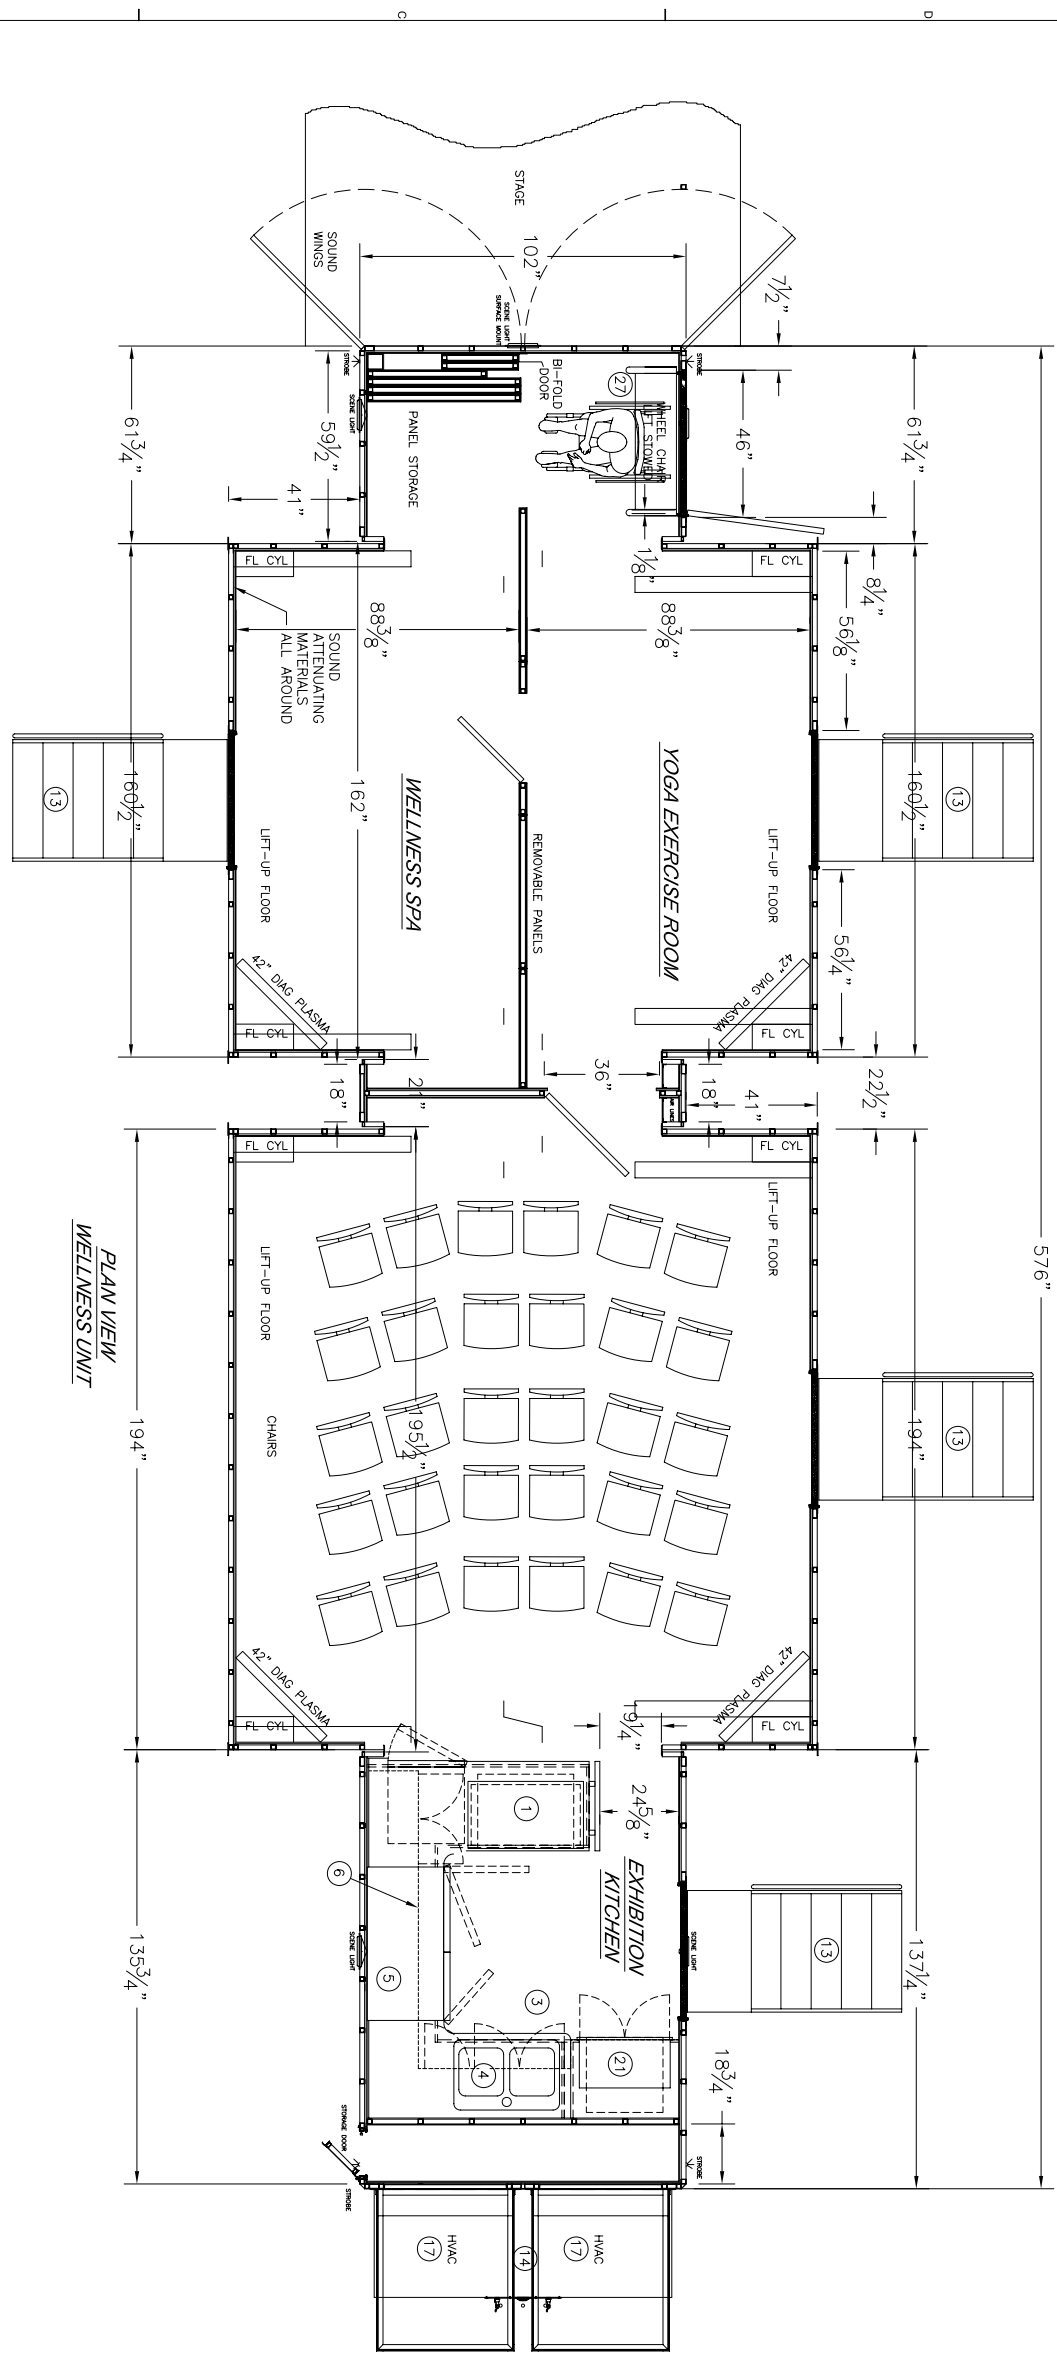

ITEM	QTY	PART NUMBER	DESCRIPTION
21	1		OVEN
20	1		LOAD CENTER - NOT SHOWN
19	1		70 GALLON FUEL TANK
18	2		DUAL SUMP SYSTEMS
17	2		HVAC, 60,000-BTU
16	1		WHEEL CHAIR LIFT
15	TBD		FRESH WATER TANK - NOT SHOWN
14	1		21KW GENERATOR
13	4		STAIR HANDRAIL, PLATFORM ASSY
12	2		SMART WATER SYSTEM
11	4		HYDRAULIC LEVELING LEGS, 32,000 LB. CAP.
10	1		AIR RIDE UPPER COUPLER (KING PIN)
9	1		AIR RIDE SUSPENSION, 34,000 LB. CAP.
8	-		OVERHEAD CABINETS
7	-		CLOSED CIRCUIT TV SYSTEM
6	-		CABINET
5	1		REFRIGERATOR
4	1		AUTOMATIC DISHWASHER
3	1		SINK
2	1		VENT HOOD
1	1		ELECTRIC RANGE

BILL OF MATERIALS

COMPANY NAME: **CUSTOMER AUTHORIZATION**

NAME (PRINT): _____ TITLE: _____

SIGNATURE: _____ DATE: _____

THIS DRAWING IS PROVIDED ON A CONFIDENTIAL BASIS SUBJECT TO RETURN ON DEMAND OF OSHKOSH SPECIALTY VEHICLES (OSHKOSH), WHICH RETAINS ALL RIGHTS ASSOCIATED WITH IT AND THE ARTICLE OR ARTICLES IT REPRESENTS. DISCLOSURE, REPRODUCTION OR ALTERATION OF ANY PART OF THIS DRAWING OR MANUFACTURE, USE OR SALE OF THE ARTICLE OR ARTICLES REPRESENTED IS PROHIBITED WITHOUT THE PRIOR WRITTEN AUTHORIZATION OF OSHKOSH. © OSHKOSH SPECIALTY VEHICLES (unpublished).

SHEET NUMBER: 1 OF 3 REFERENCE DRAWING: TITLE: MOVING EXPERIENCES WELNESS UNIT

JOB# 16745 S. LATHROP AVENUE HARVEY, IL 60426 PHONE: (708) 596-5066 FAX: (708) 596-2480

DATE: 21JAN03 SCALE: 3/8"=1'-0"

CHECKED BY: _____ DRAWN BY: _____ DRAWING NUMBER: 10241-A01

OSHKOSH SPECIALTY VEHICLES